

CE808 2/70
76A 642D

APPLICATION FOR PERMIT

SEWER-SEWAGE DISPOSAL

1

COUNTY OF LOS ANGELES
DEPARTMENT OF COUNTY ENGINEER
BUILDING AND SAFETY DIVISION
JOHN A. LAMBIE, COUNTY ENGINEER
COLEMAN W. JENKINS, SUP'T. OF BUILDING

FOR APPLICANT TO FILL IN (PRINT OR TYPE ONLY)			
LEGAL DESCRIPTION	LOT NO.	15	
BLOCK	TRACT	3989	
SIZE OF LOT	NO. OF BLDGS. NOW ON LOT	1	
USE OF BUILDINGS	BRS.		
CONTRACTOR	Carter Sanitation		
ADDRESS	4270 ELTON		
CITY	TEL. NO.	338 9538	
STATE LICENSE NO.	LIC CLASS	268016 C42	
NO.	DESCRIPTION OF WORK	FEE	
1	HOUSE SEWER CONNECTING TO PUBLIC SEWER	@ \$7.00	7.00
	SEPTIC TANK, SEEPAGE PIT OR PITS AND/OR DRAINFIELD	@ \$10.00	
	HOUSE SEWER CONNECTING TO PRIVATE DISPOSAL SYSTEM	@ \$3.00	
	CONNECT ADDITIONAL BLDG. OR WORK TO HOUSE SEWER	@ \$3.00	
	OVERFLOW SEEPAGE PIT, DRAINFIELD EXTN., CESSPOOL, DRYWELL, MANHOLE	@ \$5.00	
	ALTER, REPAIR OR ABANDON HOUSE SEWER OR DISPOSAL SYSTEM	@ \$3.00	

OWNER'S AUTHORIZATION	PERMIT	\$	3.00
	TOTAL FEE		10.00

I HAVE AT THIS DATE A CONTRACT WITH THE HEREIN NAMED CONTRACTOR TO CONNECT THE ABOVE DESCRIBED EXISTING DWELLING TO THE PUBLIC SEWER.
SIGNED THIS 29 DAY OF JAN 1975
OWNER OR OWNERS AGENT *M. Miller*

ADDRESS

I HEREBY ACKNOWLEDGE THAT I HAVE READ THIS APPLICATION AND STATE THAT THE ABOVE IS CORRECT AND AGREE TO COMPLY WITH ALL COUNTY ORDINANCES AND STATE LAWS REGULATING PLUMBING AND SEWERS.

I HEREBY CERTIFY THAT I AM PROPERLY REGISTERED AND/OR LICENSED AS REQUIRED BY LOS ANGELES COUNTY AND STATE OF CALIFORNIA OR THAT I AM THE LEGAL OWNER OF, AND INTEND TO RESIDE IN, THE ABOVE DESCRIBED RESIDENTIAL PROPERTY.

SIGNATURE OF PERMITTEE *John A. Lambie*

BUILDING ADDRESS	4660 E. MICHIGAN Ave		
LOCALITY	E.L.A.		
NEAREST CROSS ST.	St. Sander Ave		
OWNER	M. Miller CONST CO		
MAIL ADDRESS	5151 White Oak		
CITY	ENCINO	TEL. NO.	

DISTRICT NO.	GROUP	CLASS	BK	MAP	PG	PROCESSED BY
6	I		K	29		Dohman

CONNECTION DATA	
STATION	10+13. DEPTH 6'
MANHOLE REFERENCE	103.1' S. of

TYPE OF CONNECTION	LENGTH FROM M.L. TO P.L.
CURB	

CO. IMP. NO.	P.C. NO. JOB NO.
--------------	------------------

TRUNK PERMIT NO.	ROAD PERMIT NO.
------------------	-----------------

AFFIDAVIT	WAIVER	EASEMENT	RECORD. INSTR. NO.	DATE
-----------	--------	----------	--------------------	------

HWY. OR ST. WIDENING	Conn. on Sander
----------------------	-----------------

STATE ENCROACHMENT PERMIT NO.

INDUSTRIAL WASTE APPROVAL

CHARGES

CONNECTION CHARGE FEE

REIMBURSEMENT FEE

APPROVALS	DATE	INSPECTOR'S SIGNATURE
NEW HOUSE SEWER	1-29-75	Dohman
CONNECT ADDITIONAL BUILDING OR WORK		
SEPTIC TANK, SEEP. PIT(S) AND/OR DRAINFIELD		
CESSPOOL <input type="checkbox"/> DRYWELL <input type="checkbox"/>		
ALTER, REPAIR, SEWER OR SEWAGE DISPOSAL SYSTEM		
DISCONNECT PLUG AND ABANDON HOUSE SEWER		
BACKFILL SEPTIC TANKS <input type="checkbox"/> SEEP. PIT(S) <input type="checkbox"/> CESSPOOLS <input type="checkbox"/>		

VALIDATION
CK. M. O. CASH

JACK R. ALLEN
SUPERVISING MECHANICAL ENGINEER

409 JAN 29 1975

10.00


Dohman

INSPECTOR COPY

FOR DEPARTMENT USE

REQUIRED INFORMATION

1. INDICATE ALL BUILDINGS ON PROPERTY.
2. INDICATE AND DIMENSION SEWAGE DISPOSAL SYSTEM WITH TIE DISTANCES TO BUILDINGS AND PROPERTY LINES.
3. INDICATE SIZE OF SEPTIC TANK—DEPTH OF SEEPAGE PIT(S)—SIZE OF CESSPOOL(S).
4. INDICATE NORTH DIRECTION ON PLOT.
5. INDICATE BOTH STREETS IF CORNER.

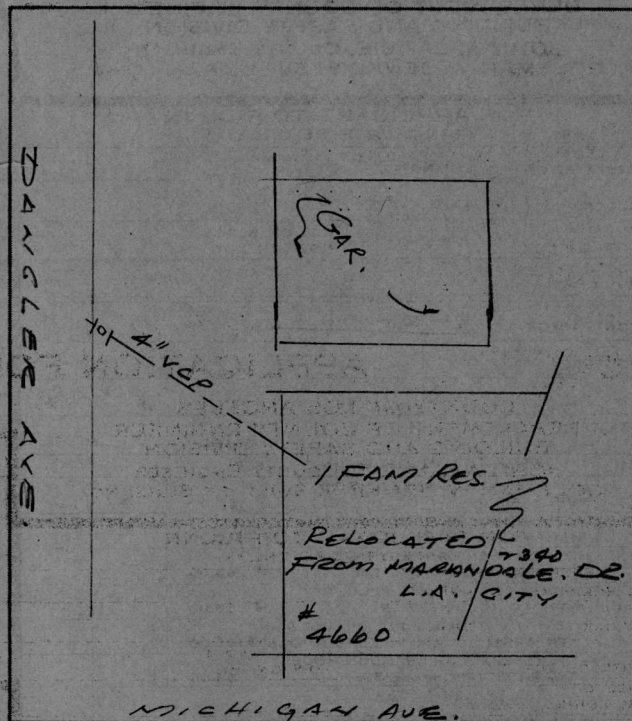

ST. ALLEY R/W

1-29-75

4" VCP SEWER - WATER TESTED OK

NOTE: 4" PLASTIC STUB OUT FROM BLDG.

TO BE INSTALLED 18" BELOW GRADE

OR PLACE UNDER CONCRETE. F. GALLEGO

FIELD NOTES

00001

A. G. R. M. R. O. T.